



I, Neville H Volker, hereby certify that the horizontal and vertical locations, and dimensions shown on this plan are a true and correct record of the As Constructed information.

OW / 14.1 / 2018  
 Project Name Davidsons at Bellivah - Stage 1B  
 Company BELIVAH PTY LTD  
 Consultant NH Volker & Co Pty Ltd  
 Reg No 2753  
 Signature *NH Volker* Date 15/04/2019

**NH Volker**  
 M. Reg. No. Grad. Dip. U.R.P.  
 P/Cadastral Surveyor  
 Email: nvolker@bigpond.net.au Mbl. Phone 0411 759 785

**Associated Consultant**  
 PREMISE ENGINEERING PTY LTD  
 LEVEL 1, 100 BRUNSWICK STREET  
 P.O. Box 361  
 FORTITUDE VALLEY QLD 4006

**CLIENT**  
 PLANLEX PTY. LTD.  
 P O Box 411  
 BEENLEIGH QLD 4207  
 Email - nvolker@bigpond.net

**PROJECT**  
 DAVIDSONS at BELIVAH  
 STAGE 1B  
 Bellivah Road, BELIVAH

**DRAWING**  
 AS CONSTRUCTED ROADWORKS  
 AND STORMWATER DRAINAGE  
 PLAN - STAGE 1B - SHEET 1 of 6

**AS CONSTRUCTED**




A ORIGINAL ISSUE		DATE	04/19
REVISION		DATE	

DRAWN	AB / RMM	DATE	04/19
APPROVED		DATE	
DWG. NO.	DB1B AC-C01	REVISION	A

REFER TO DWG. DB1B AC - C02 FOR CONTINUATION

REFER TO DWG. DB1B AC - C03 FOR CONTINUATION

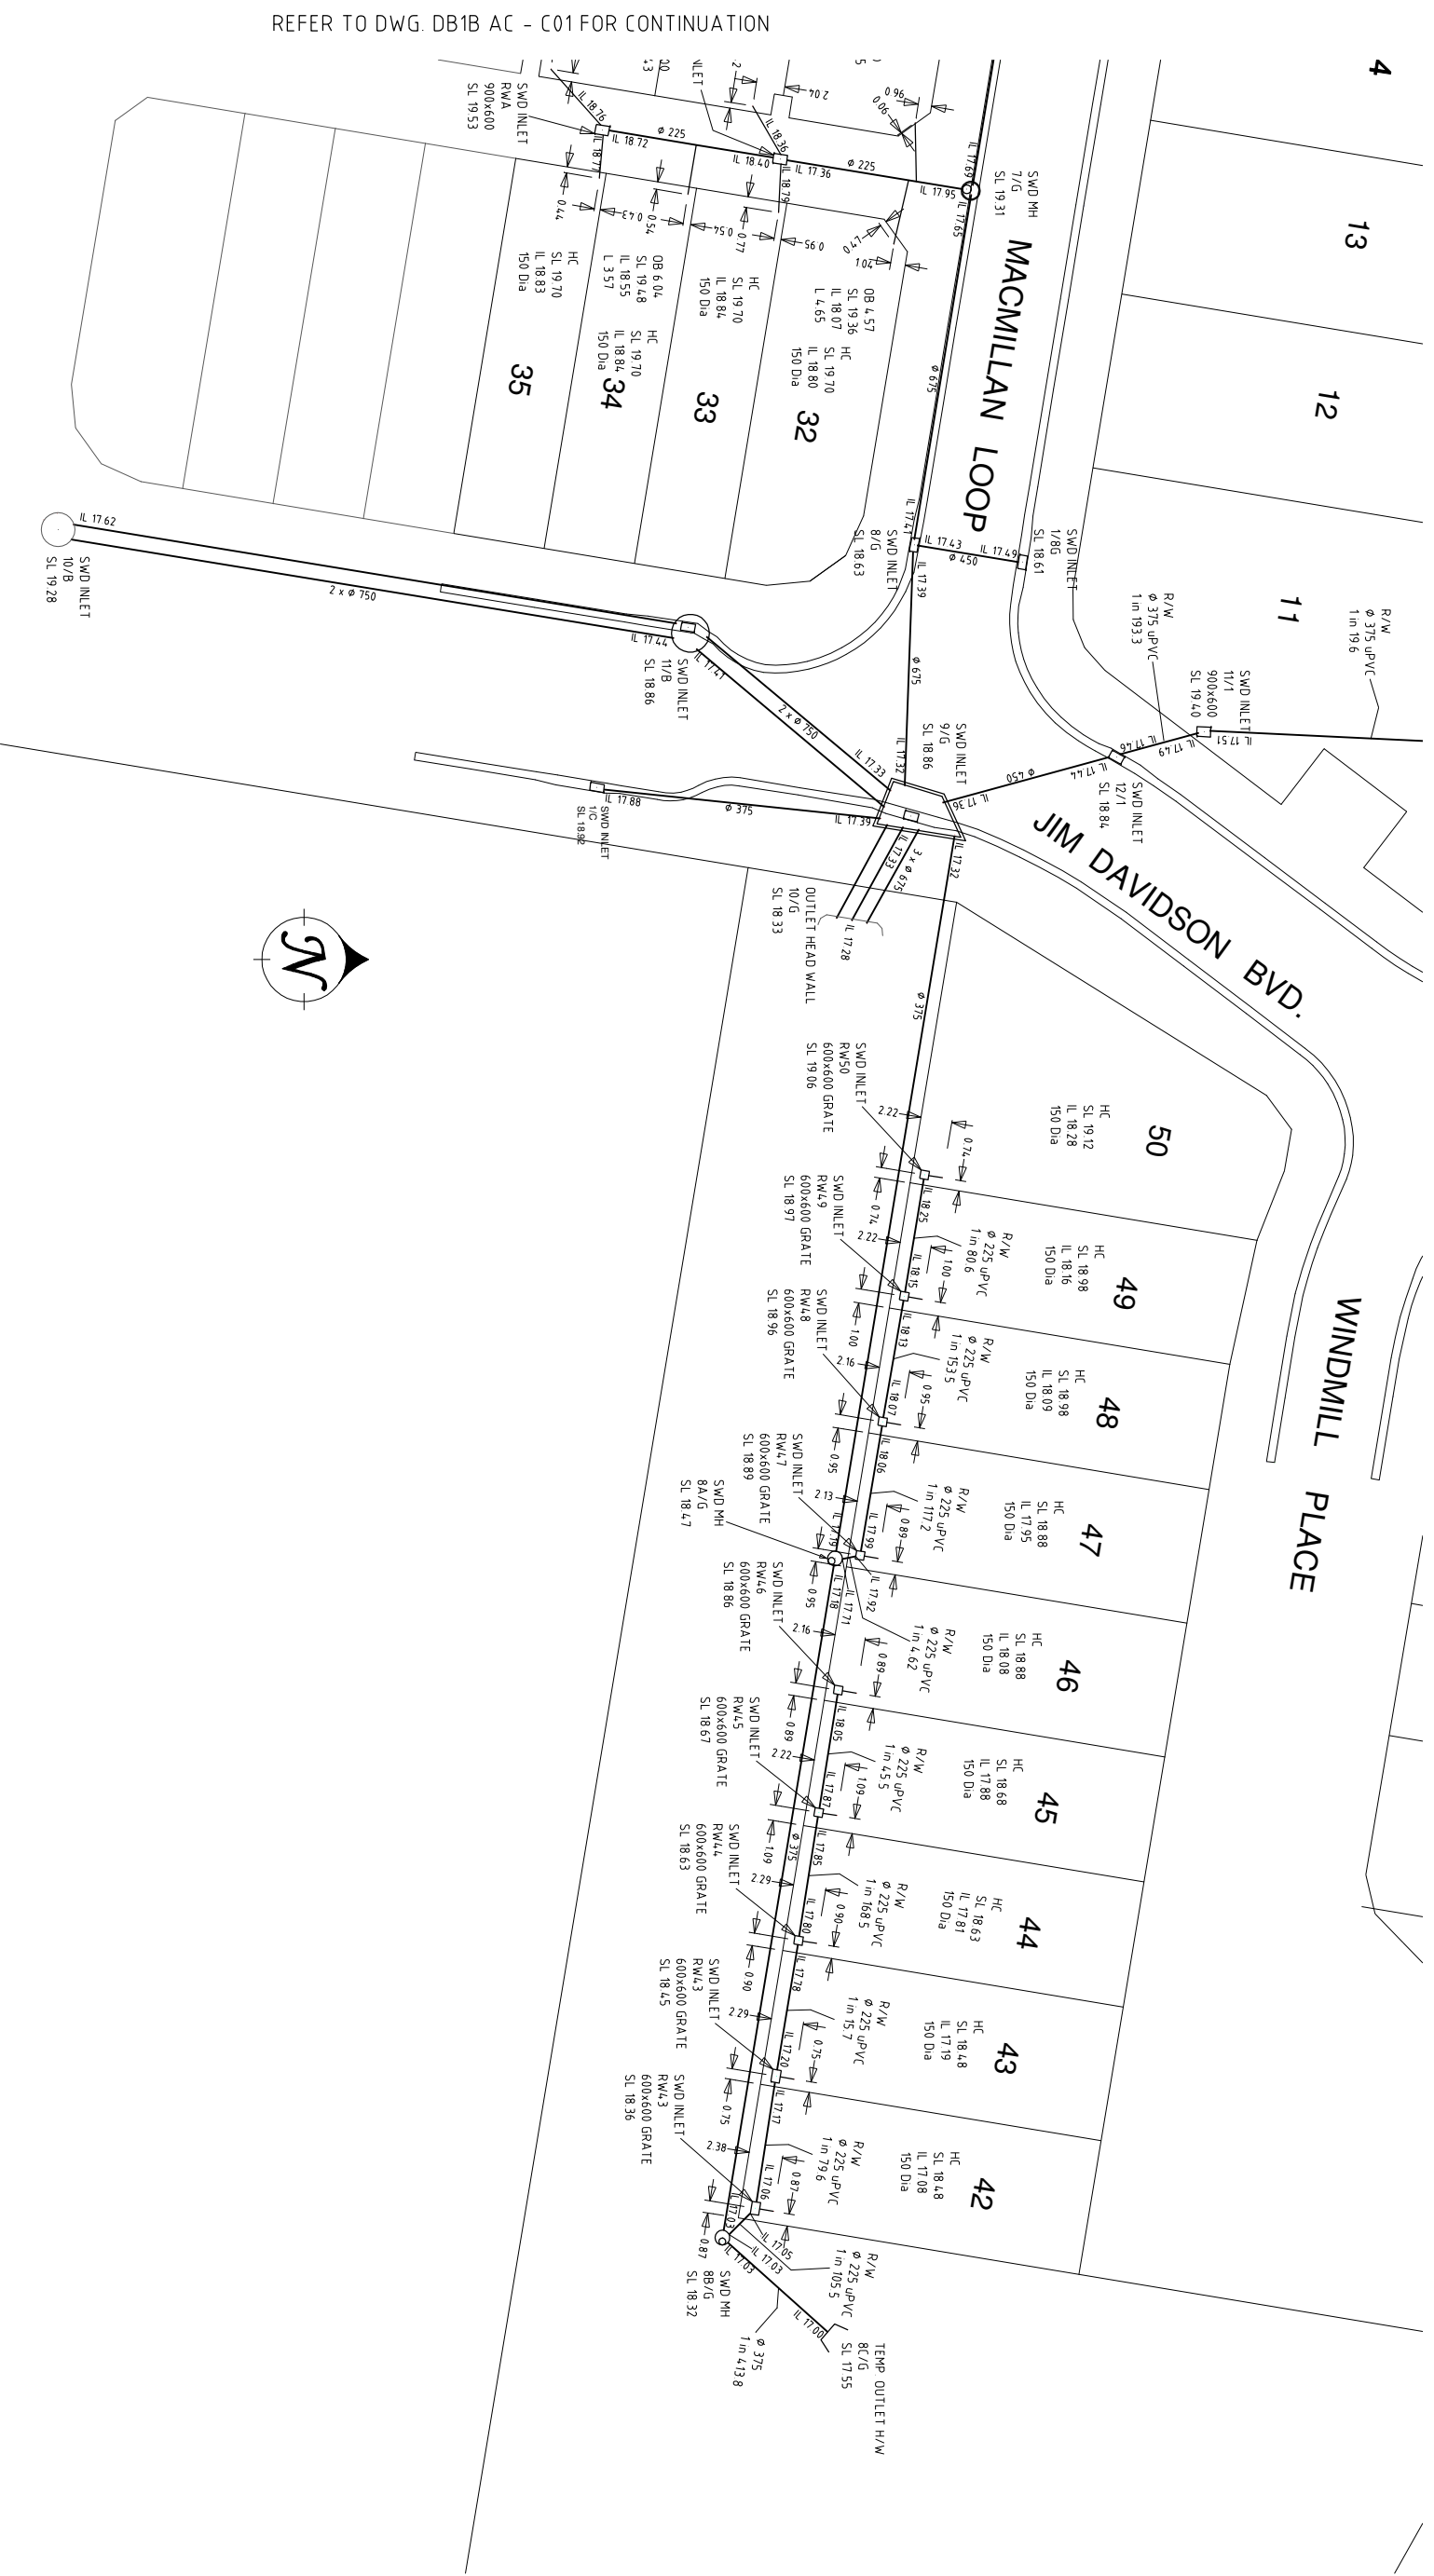

REFER TO DWG. DB1B AC - C01 FOR CONTINUATION

I, Neville H Volker, hereby certify that the horizontal and vertical locations and dimensions shown on this plan are a true and correct record of the As Constructed information.

OW / 14.1 / 2018  
 Project Name: Davidsons at Belivah - Stage 1B  
 Company: BELIVAH PTY LTD  
 Consultant: N H Volker & Co Pty Ltd  
 Reg No: 2753  
 Signature: *NH Volker* Date: 15/04/2019

**AS CONSTRUCTED**



SCALE 1500 (A3 SIZE)  
 SCALE 1250 (A1 SIZE)

**NH Volker**  
 M. Reg. Sc.  
 Grad. Dip. U.R.P.  
 P/Cadastral Surveyor  
 Email: nvolker@bigpond.net.au Mbl. Phone 0411 759 765

**Associated Consultant**  
 PREMIERE ENGINEERING PTY LTD  
 LEVEL 1, 100 BRUNSWICK STREET  
 P.O. Box 361  
 FORTITUDE VALLEY QLD 4006


**CLIENT**  
 PLANLEX PTY. LTD.  
 P O Box 411  
 BEENLEIGH QLD 4207  
 Email - nvolker@bigpond.net

**PROJECT**  
 DAVIDSONS at BELIVAH  
 STAGE 1B  
 Belivah Road, BELIVAH


**DRAWING**  
 AS CONSTRUCTED ROADWORKS  
 AND STORMWATER DRAINAGE  
 PLAN - STAGE 1B - SHEET 2 of 6

DESIGNED	AB / RMM	DATE	04/19
APPROVED		DATE	
DWG. NO.	DB1B AC-C02	REVISION	A

A ORIGINAL ISSUE	REVISION	DATE	04/19

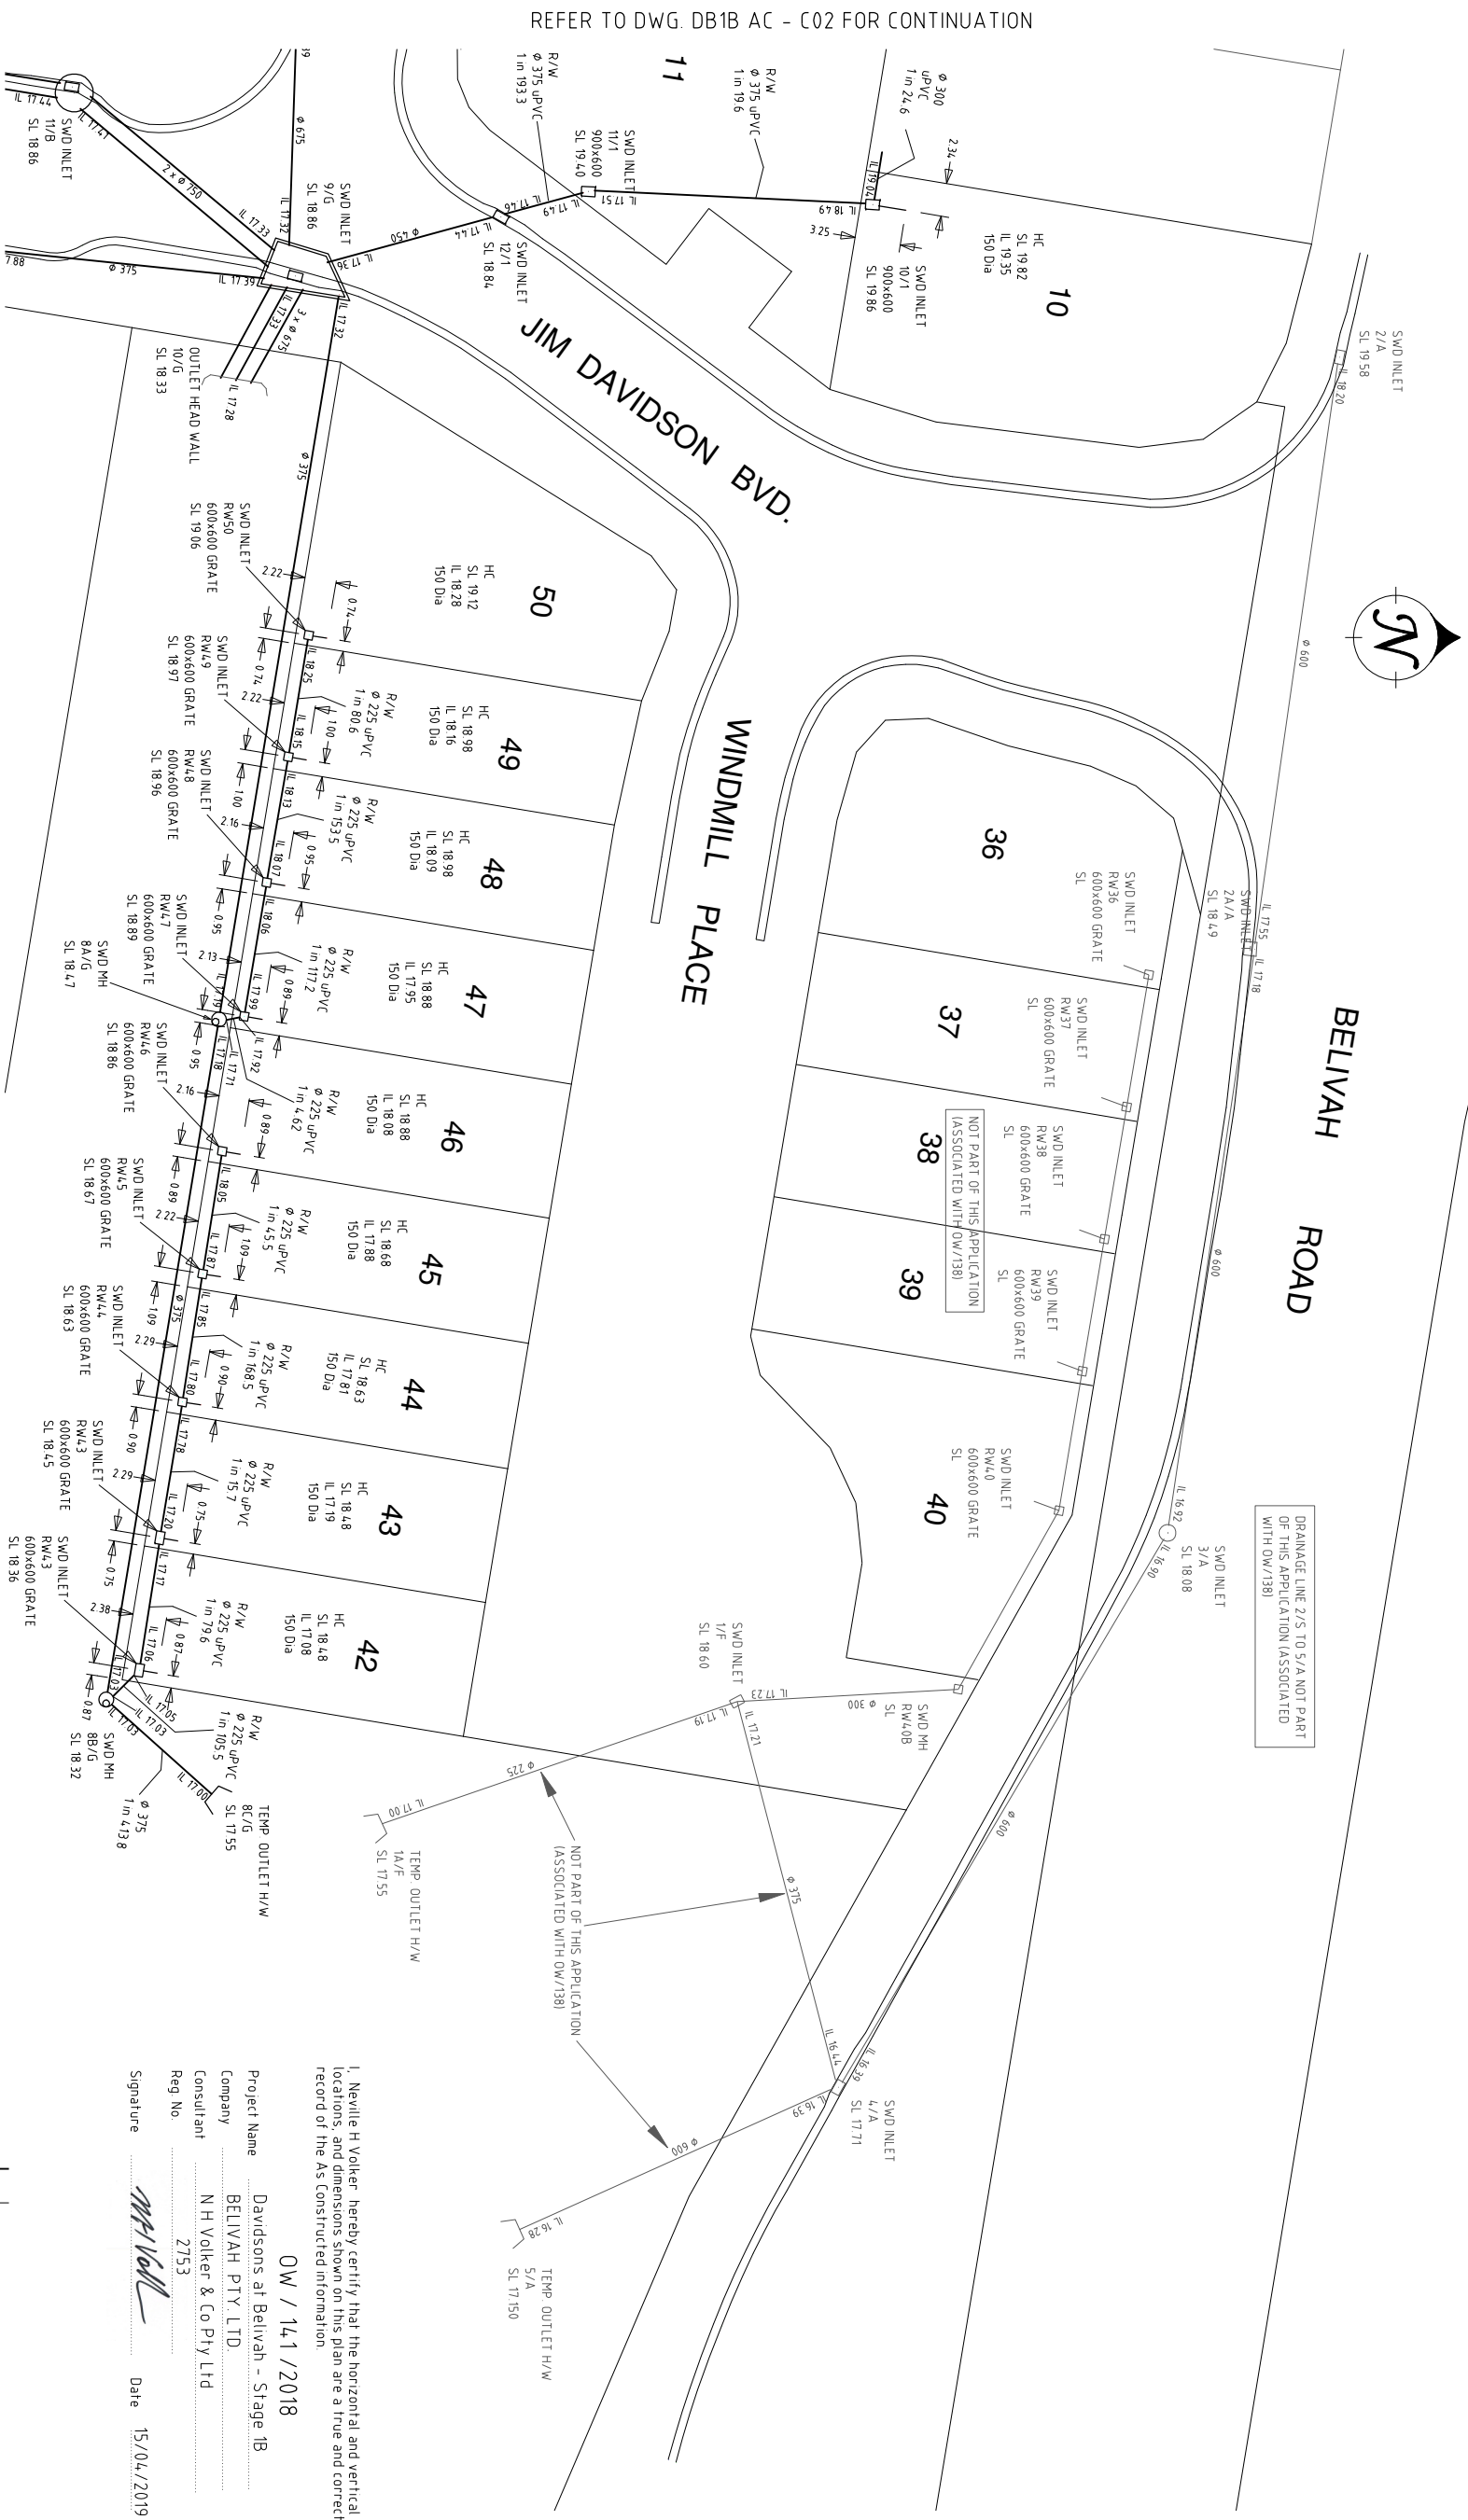

REFER TO DWG. DB1B AC - C02 FOR CONTINUATION

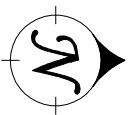

**AS CONSTRUCTED**



I, Neville H Volker, hereby certify that the horizontal and vertical locations, and dimensions shown on this plan are a true and correct record of the As Constructed information.

OW / 14.1 / 2018  
 Davidsons at Bellivah - Stage 1B  
 Project Name  
 BELIVAH PTY. LTD.  
 Company  
 N H Volker & Co Pty Ltd  
 Consultant  
 Reg No 2753  
 Signature *NH Volker*  
 Date 15/04/2019

DATE	04/19
REVISION	DATE
A ORIGINAL ISSUE	04/19

**N H Volker**  
 M. Reg. Sc.  
 Grad. Dip. U.R.P.  
 Professional Surveyor  
 Email: nvolker@bigpond.net.au Mbl. Phone 0411 759 785

**Associated Consultant**  
 PREMIERE ENGINEERING PTY. LTD  
 LEVEL 1, 100 BRUNSWICK STREET  
 P.O. Box 361  
 FORTITUDE VALLEY QLD 4006

**CLIENT**  
 PLANLEK PTY. LTD.  
 P O Box 411  
 BEENLEIGH QLD 4207  
 Email - nvolker@bigpond.net

**PROJECT**  
 DAVIDSONS at BELIVAH  
 STAGE 1B  
 Belivah Road, BELIVAH

**DRAWING**  
 AS CONSTRUCTED ROADWORKS  
 AND STORMWATER DRAINAGE  
 PLAN - STAGE 1B - SHEET 5 of 6

DATE	04/19
REVISION	DATE
AB / RYM	04/19
DB1B AC-C03	A