



LEGEND

- 23 — DESIGN CONTOURS MAJOR
- - - 23 - - - DESIGN CONTOURS MINOR
- STORMWATER MANHOLE
- ⊠ STORMWATER GULLYTRAP
- ⊞ WATER METER
- ⊙ WATER HYDRANT
- SEWER MANHOLE
- W — WATER
- S — SEWER
- SW — STORMWATER
- ⊘ WATER SERVICE VALVE
- ▽ BUILD TO BOUNDARY
- ▬▬▬ KERB & CHANNEL
- ROAD CENTRELINE
- ⊙ STREET LIGHT
- UE — ELECTRICITY (U/G)
- NBN — NBN (COMMUNICATIONS)
- FOOTPATH
- DRIVEWAY
- BUILDING ENVELOPE
- INDICATES DIRECTION OF TYPICAL FALL OF 0.2m
- ⊞ SUBSTATION

Add 9°24'40"
 for MGA
 Zone 56

See also
SHEET 2
 of this drawing
 which refers to
 Bldg Envelope
 Logan PD Online
 Com/5/2023
 Approved Plans
 Sheet 9
 Bldg Setbacks

Scale 1 : 300 (at A4)

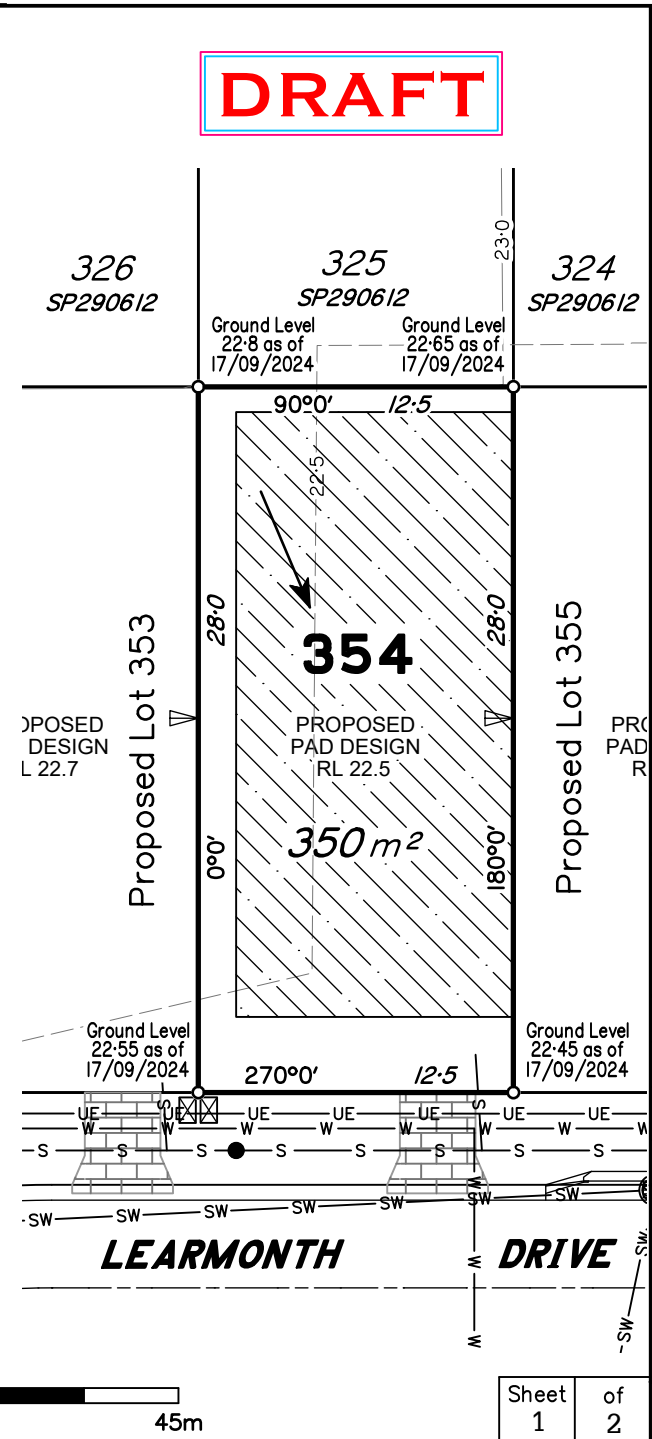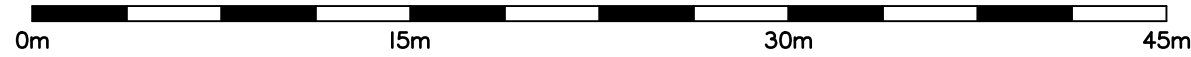

Sheet 1 of 2

DISCLOSURE PLAN
 For Lot **354** (on SP290613)
 Learmonth Drive
 BELIVAH, QLD

Sheet 1 of 2

Described as Part of Lot 600 on SP290612
 Local Authority: LOGAN C.C.
 Map Ref: 9542-31411

IMPORTANT NOTES:
 These notes are an integral part of the plan. This plan has been prepared for Davidsons At Belivah for the purposes of a **Disclosure Plan under the Land Sales Act 1984**. It is not to be used for any other purpose and is subject to the following limitations. The lot dimensions and areas shown hereon are subject to final survey and also subject to Council and other authorities. Notwithstanding the limits of filling shown, the actual limits shall be determined on site by the engineer during construction. Compaction of any fill material placed on this site shall be completed under inspection and testing services in accordance with AS3798-2007. Location of sewer, stormwater, water, electric and communications are shown from engineering drawings and may differ from the as constructed location. These drawings are copyright and are not to be used or reproduced without the written permission of NH Volker and Co Pty Ltd.

AUTHORISATION:

Neville Henry VOLKER
 Cadastral Surveyor

DATE	24/10/24	SURVEYED	—
SCALE	1 : 300 (A4)	DRAWN	BD24291
LEVEL DATUM	A.H.D	CHECKED	NHV
CONTOUR INTERVAL	0.5m		



DRAWING NO: BLV015_DP 354

BD24291

BUILDING ENVELOPE PLAN

DAVIDSONS AT BELIVAH STAGE 3C



SCALE: 1:750 @ A3

NOTES:

1. THIS SHEET MUST READ IN CONJUNCTION WITH PLAN No. DB-1-CF SHEET 9 V1
2. AVAILABLE BUILD AREA MAY BE REDUCED BY EASEMENTS AND OTHER INFRASTRUCTURE


STAGE 3C STATISTICS		
LOT SIZE	NO.	%
G.T. 500m ²	13	41
400-500m ²	4	13
300-400m ²	12	39
L.T. 300m ²	2	7
TOTAL	31	100

- NO VEHICLE ACCESS
- DEVELOPMENT ENVELOPE
- BUILD TO BOUNDARY
- STAGE BOUNDARY
- P** PRIMARY STREET FRONTAGE

STREET SETBACK	SETBACKS (unless notified otherwise)				
	LOT WIDTH				
	< 14m	14m - 20m		> 20m	
	GROUND & UPPER	GROUND	UPPER	GROUND	UPPER
PRIMARY STREET	3m	4m	4m	4.5m	4.5m
SECONDARY STREET	2m	2m	2m	2m	2m
SIDE & REAR SETBACK	1m	1m	1.5m	1.5m	2m

NOTES:
 1. SETBACKS ARE MEASURED TO THE BUILDING WALL.
 2. FRONT SETBACK MAY BE REDUCED 1.5M FOR VERANDAH ENTRY TO PATIO.
 3. SETBACKS TO ALL FRONTAGES ARE REDUCED BY 1.5m FOR A VERANDAH, PORCH, COVERED FIRST FLOOR BALCONY OR ENTRY PORTICO.
 4. GARAGE DOORS ARE TO BE SETBACK 5m FROM THE STREET FRONTAGE

LOGAN CITY COUNCIL
APPROVED PLAN OF DEVELOPMENT
 This is the approved plan of development for Development Application
COM/5/2023

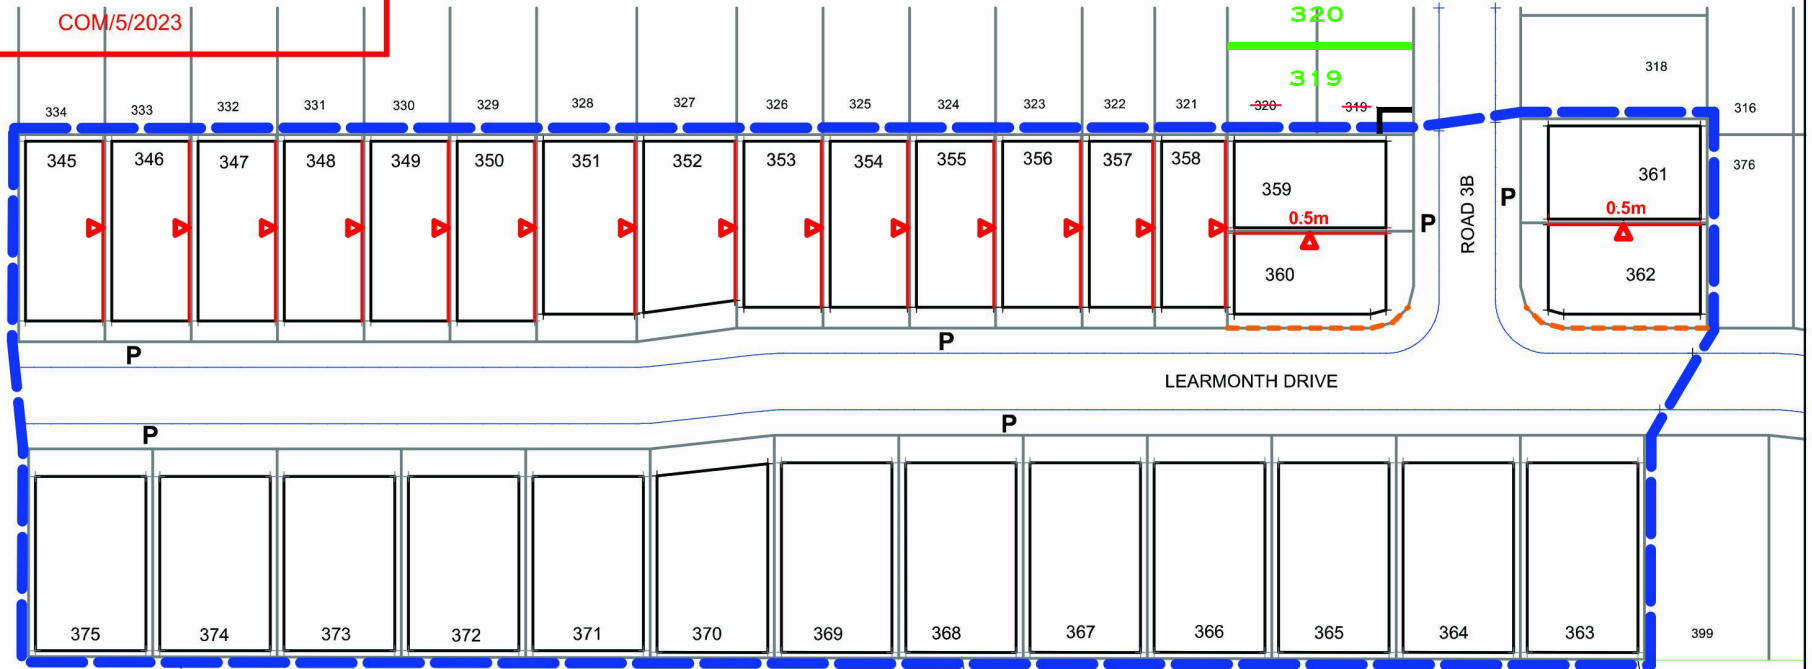

Driveway to be constructed to LCC specifications

	PREPARED BY: N H VOLKER & Co. PTY. LTD. P O Box 411 BEENLEIGH QLD 4207 EMAIL: nvolker@bigpond.net.au	CLIENT: BELIVAH PTY. LTD.	PROPOSED LOTS 345-375	PROJECT : DAB - STAGES 3C LOCATION: JIM DAVIDSON BLVD, BELIVAH	Job No. - DB-3-ABCD SHEET No. - 9 OF 11 REVISION. - V2	DATE: 17/02/2023 DRAWN: AB EMAIL: nvolker@bigpond.net.au PH: 0411 759 765
--	--	---------------------------	------------------------------	--	--	--