

I, Neville H Volker hereby certify that the horizontal and vertical locations, dimensions shown on this plan are a true and correct record of the As Constructed information.


Project Name - DAVIDSONS AT BELIVAH - STAGE 1F

Company - BELIVAH Pty Ltd

Consultant - N H Volker & Co Pty Ltd

Reg No - 2753


Signature - *NH Volker* DATE 28/11/2020

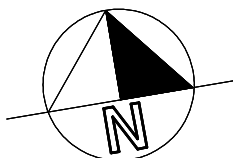

SCALE: 1: 500 @ A3

**COUNCIL REF. No. - OW/132/2020/1**

ASSOCIATED CONSULTANT N H VOLKER & Co. PTY. LTD. P O Box 411 BEENLEIGH QLD 4207 EMAIL: nvolker@bigpond.net.au	JBT CONSULTING - BRAD TITE PO Box 1350 SPRINGWOOD QLD 4150 PH 07 3207 3399 RPEQ 2673 Mbl. Phone: 0408 712 538 Email: btite@jbtconsulting.com.au	<b>DAVIDSONS AT BELIVAH          AS CONSTRUCTED          SEWER RETICULATION PLAN          STAGE 1F SHEET 1 OF 2</b>	PROJECT : STAGE 1F LOCATION: WALKER AVENUE, BELIVAH SHEET TITLE: AS CONSTRUCTED - SEWER RETIC	DRAWING No. - DAB-1F-S01AC SHEET No. - 1 OF 2 REVISION. - A	<b>APPROVED:</b> <b>BRAD TITE - RPEQ 2673</b> DATE: 24/11/20	DATE: 24/11/2020 DRAWN: AB EMAIL: nvolker@bigpond.net.au PH: 0411 759 765
---	---	---	---	---	--	--

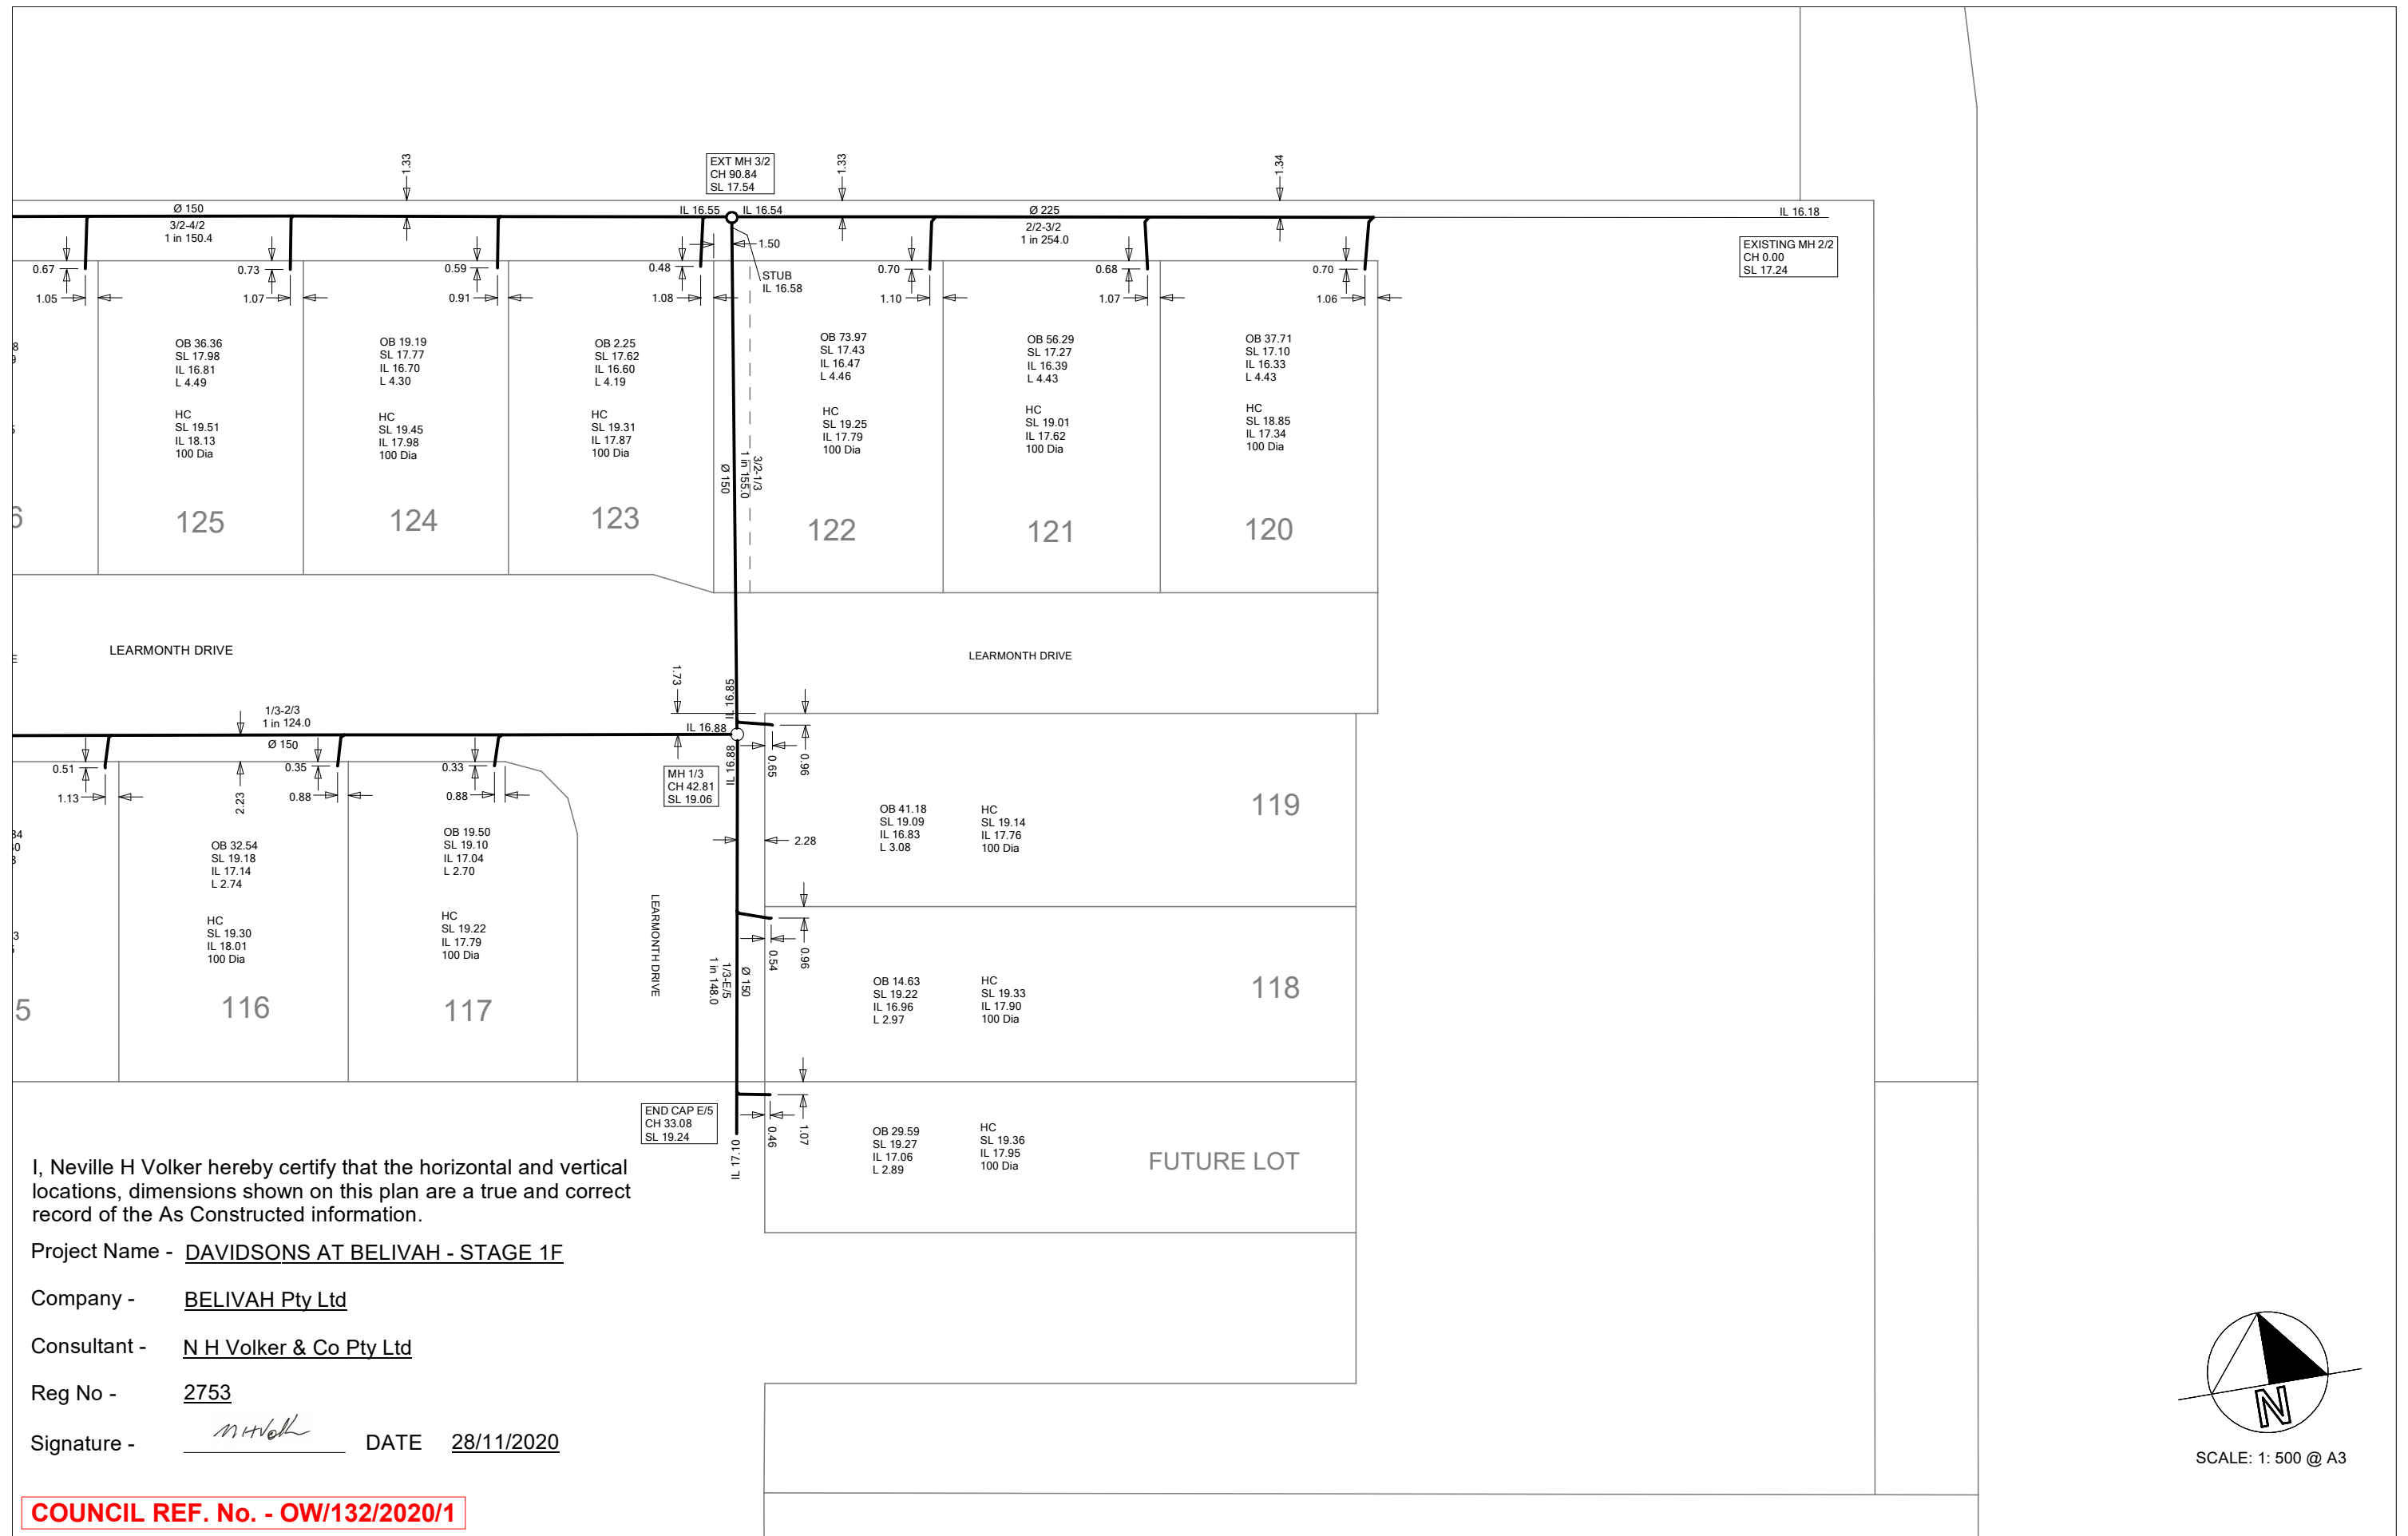

I, Neville H Volker hereby certify that the horizontal and vertical locations, dimensions shown on this plan are a true and correct record of the As Constructed information.

Project Name - DAVIDSONS AT BELIVAH - STAGE 1F


Company - BELIVAH Pty Ltd

Consultant - N H Volker & Co Pty Ltd

Reg No - 2753

Signature - *NH Volker* DATE 28/11/2020

**COUNCIL REF. No. - OW/132/2020/1**

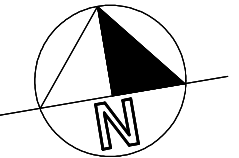

SCALE: 1: 500 @ A3

ASSOCIATED CONSULTANT N H VOLKER & Co. PTY. LTD. P O Box 411 BEENLEIGH QLD 4207 EMAIL: nvolker@bigpond.net.au	JBT CONSULTING - BRAD TITE PO Box 1350 SPRINGWOOD QLD 4150 PH 07 3207 3399 RPEQ 2673 Mbl. Phone: 0408 712 538 Email: btite@jbtconsulting.com.au	<b>DAVIDSONS AT BELIVAH          AS CONSTRUCTED          SEWER RETICULATION PLAN          STAGE 1F SHEET 2 OF 2</b>	PROJECT : STAGE 1F LOCATION: WALKER AVENUE, BELIVAH SHEET TITLE: AS CONSTRUCTED - SEWER RETIC	DRAWING No. - DAB-1F-S02AC SHEET No. - 2 OF 2 REVISION. - A	<b>APPROVED:</b> <b>BRAD TITE - RPEQ 2673</b> DATE: 24/11/20	DATE: 24/11/2020 DRAWN: AB EMAIL: nvolker@bigpond.net.au PH: 0411 759 765
---	---	---	---	---	--	--