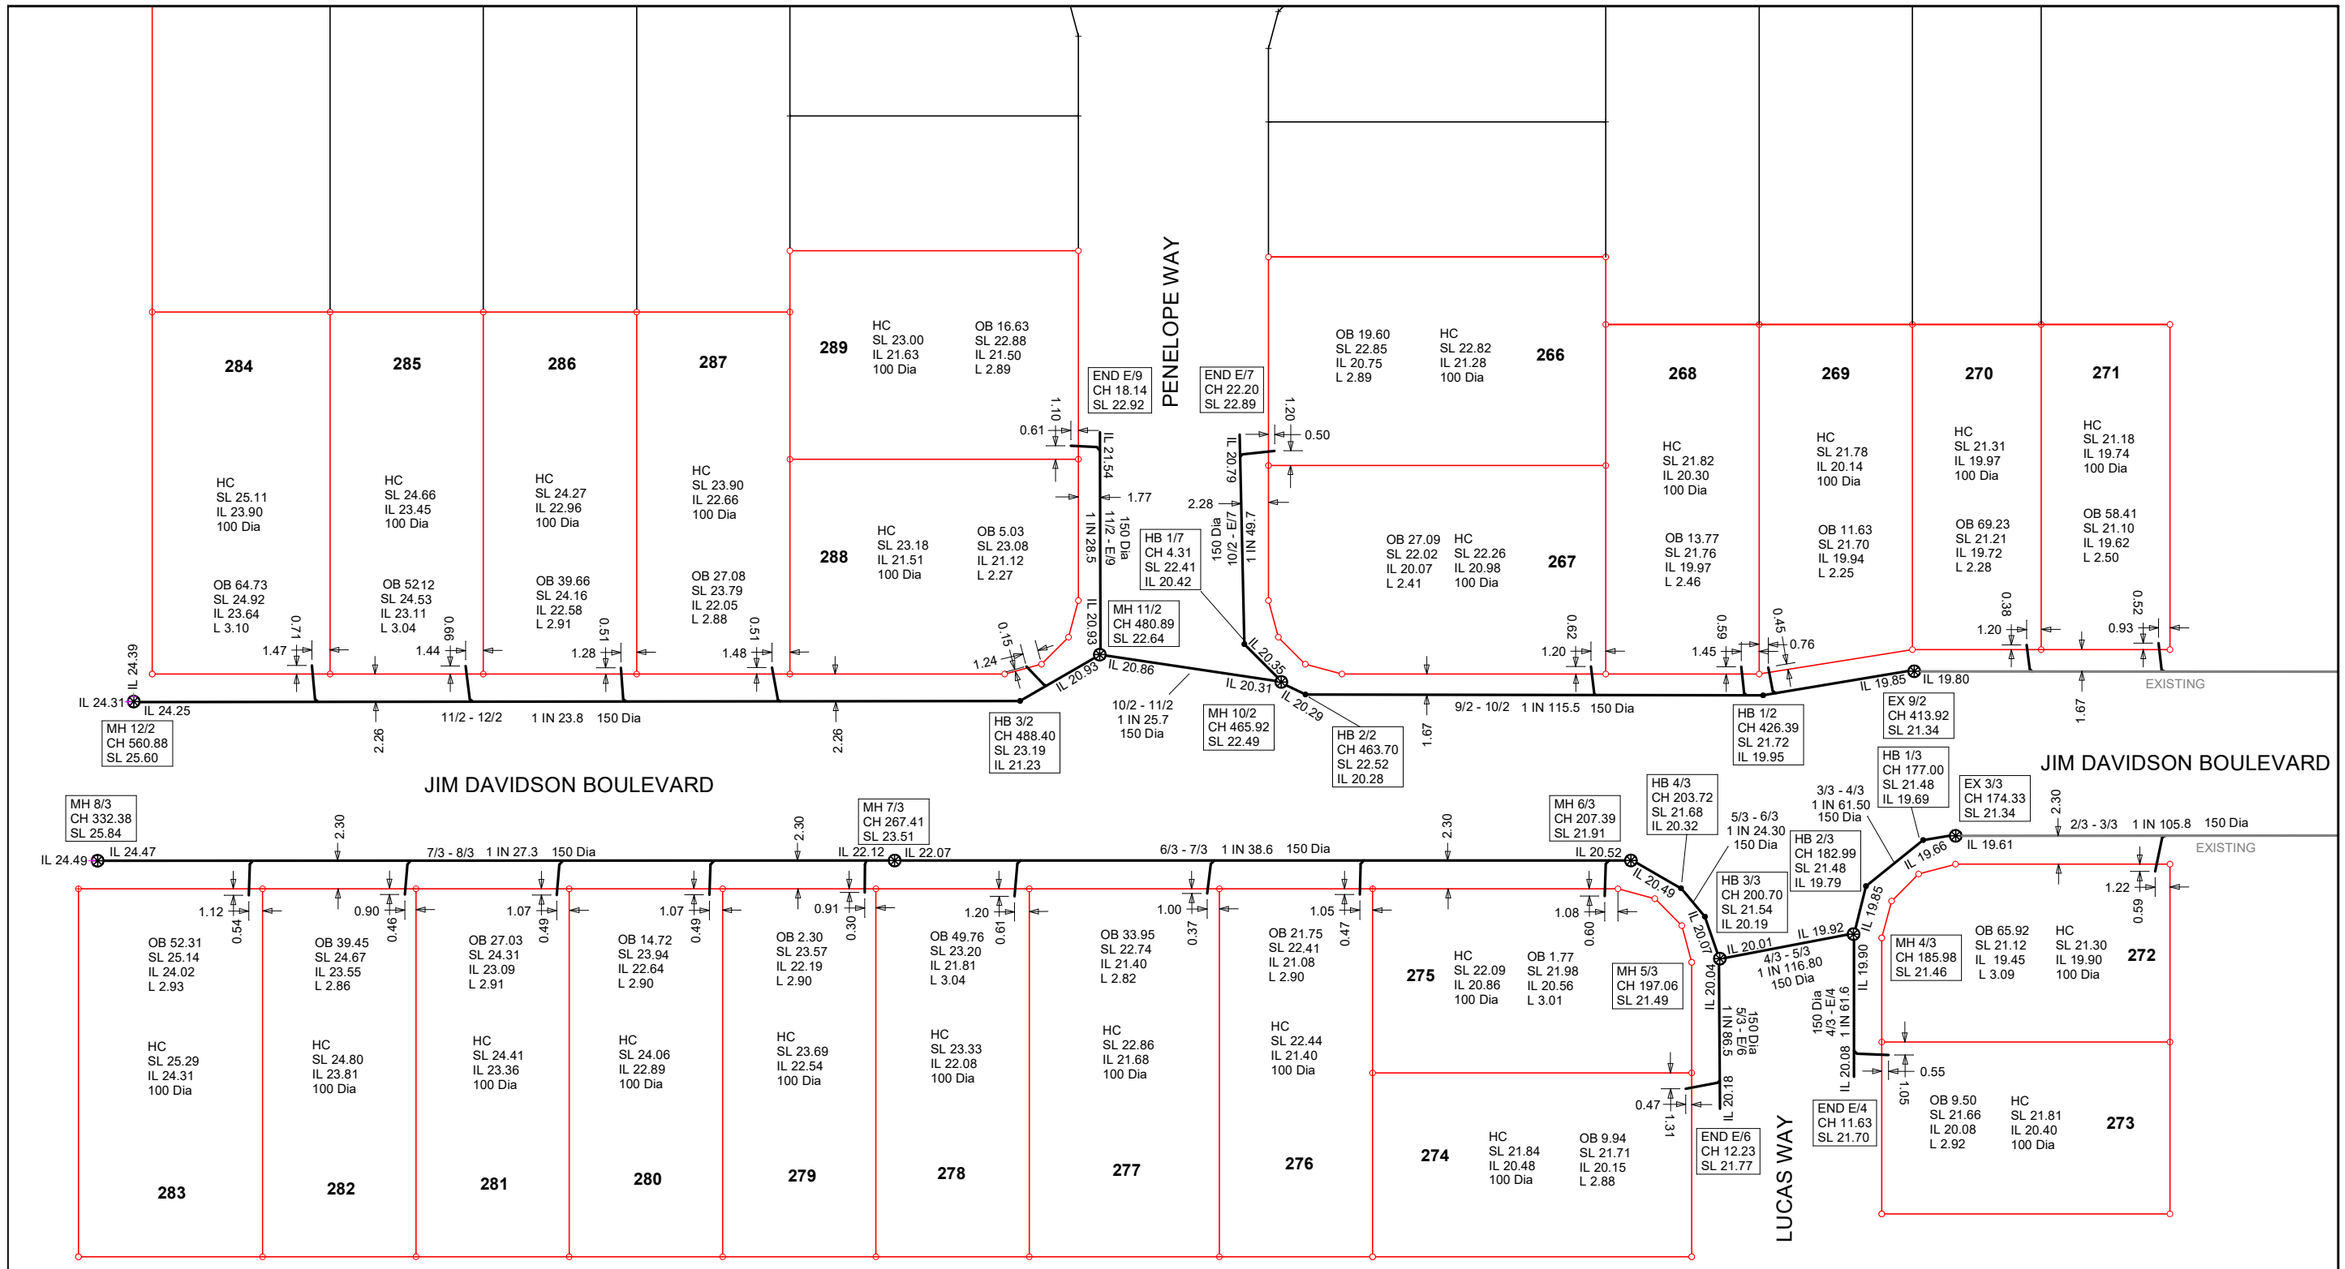

1:500 @ A3

COUNCIL REF. No. - OW/170/2023

Project Name - DAVIDSONS AT BELIVAH - STAGE 3A

Company - BELIVAH Pty Ltd

Consultant - N H Volker & Co Pty Ltd

Reg No - 2753 DATE 08/04/2024 Signature -

I, Neville H Volker hereby certify that the horizontal and vertical locations, dimensions shown on this plan are a true and correct record of the As Constructed information.

Davidson's At BELIVAH

ASSOCIATED CONSULTANT N H VOLKER & Co. PTY. LTD. P O Box 411 BEENLEIGH QLD 4207 EMAIL: nvolker@bigpond.net.au	JBT CONSULTING - BRAD TITE PO Box 1350 SPRINGWOOD QLD 4150 PH 07 3207 3399 RPEQ 2673 Mbl. Phone: 0408 712 538 Email: btite@jbtconsulting.com.au	**DAVIDSONS AT BELIVAH AS CONSTRCUTED SEWER RETICULATION PLAN STAGE 3A**	PROJECT : STAGE 3A LOCATION: JIM DAVIDOSN BOULEVARD BELIVAH SHEET TITLE: AS CONSTRUCTED - SEWER RETIC	DRAWING No. - DAB-3A-S01AC SHEET No. - 1 OF 1 REVISION. - A	**APPROVED:** **BRAD TITE - RPEQ 2673** **DATE: 08/04/2024**	DATE: 08/04/2024 DRAWN: AB EMAIL: nvolker@bigpond.net.au PH: 0411 759 765

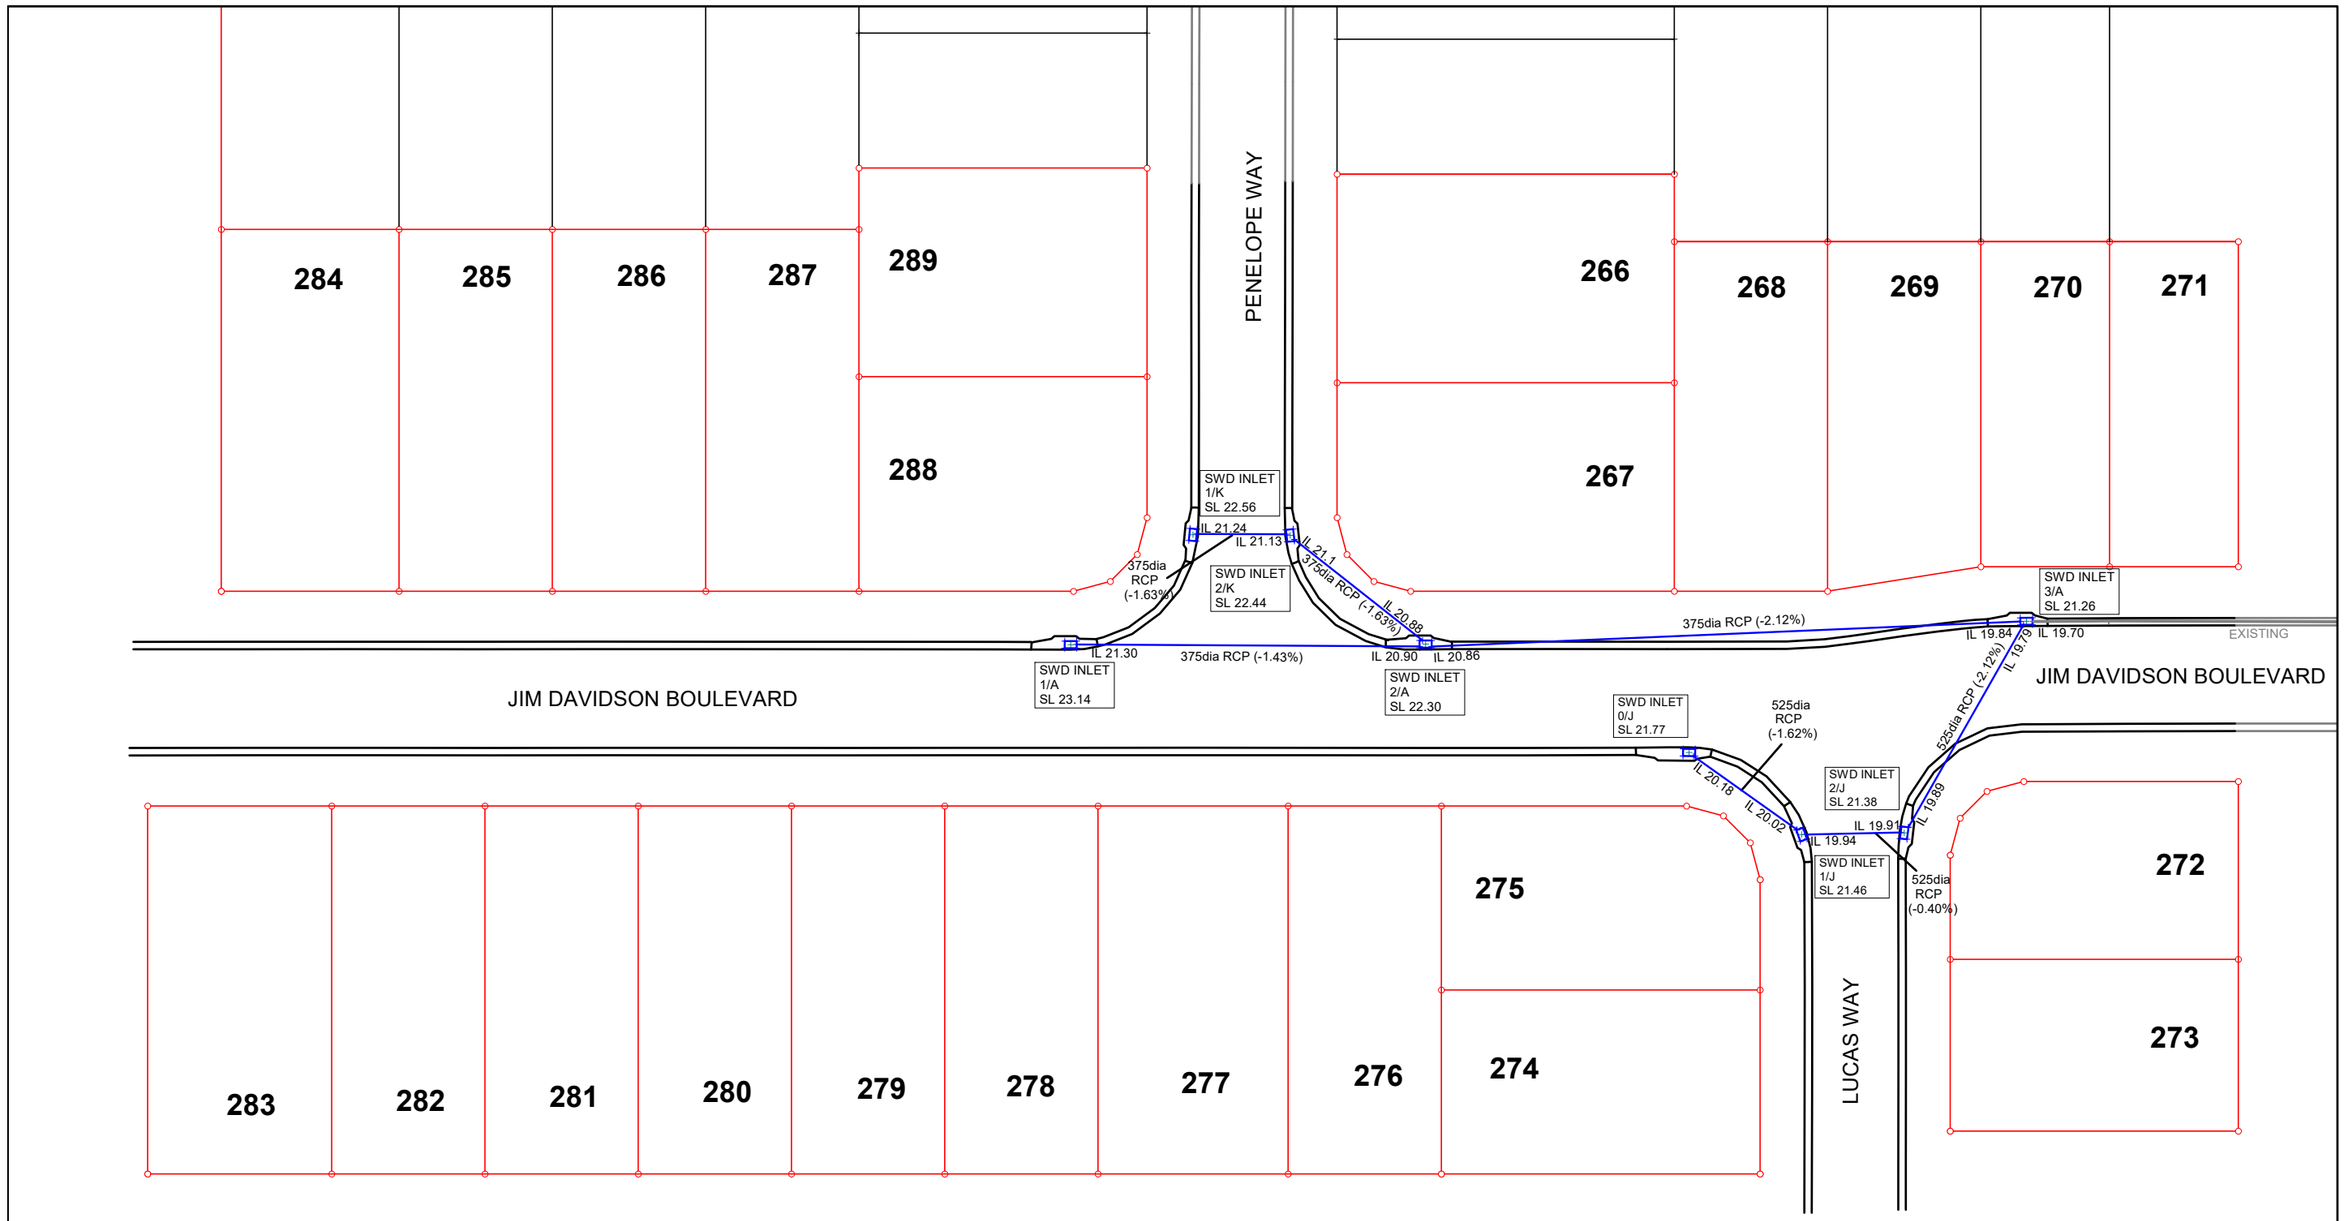

1:500 @ A3

COUNCIL REF. No. - OW/170/2023

Project Name - DAVIDSONS AT BELIVAH - STAGE 3A

Company - BELIVAH Pty Ltd

Consultant - N H Volker & Co Pty Ltd

Reg No - 2753 DATE 08/04/2024 Signature -

I, Neville H Volker hereby certify that the horizontal and vertical locations, dimensions shown on this plan are a true and correct record of the As Constructed information.

Davidson's At BELIVAH

ASSOCIATED CONSULTANT
N H VOLKER & Co. PTY. LTD.
P O Box 411
BEENLEIGH QLD 4207
EMAIL: nvolker@bigpond.net.au

JBT CONSULTING - BRAD TITE
PO Box 1350
SPRINGWOOD QLD 4150
PH 07 3207 3399 RPEQ 2673
Mbl. Phone: 0408 712 538 Email: btite@jbtconsulting.com.au

DAVIDSONS AT BELIVAH AS CONSTRCUTED STORMWATER & ROADS PLAN STAGE 3A

PROJECT : STAGE 3A
LOCATION: JIM DAVIDOSN BOULEVARD BELIVAH

SHEET TITLE: AS CONSTRUCTED - SWD

DRAWING No. - DAB-3A-SWDAC

SHEET No. - 1 OF 1

REVISION. - A

APPROVED:

BRAD TITE - RPEQ 2673

DATE: 08/04/2024

DATE: 08/04/2024
DRAWN: AB
EMAIL: nvolker@bigpond.net.au
PH: 0411 759 765

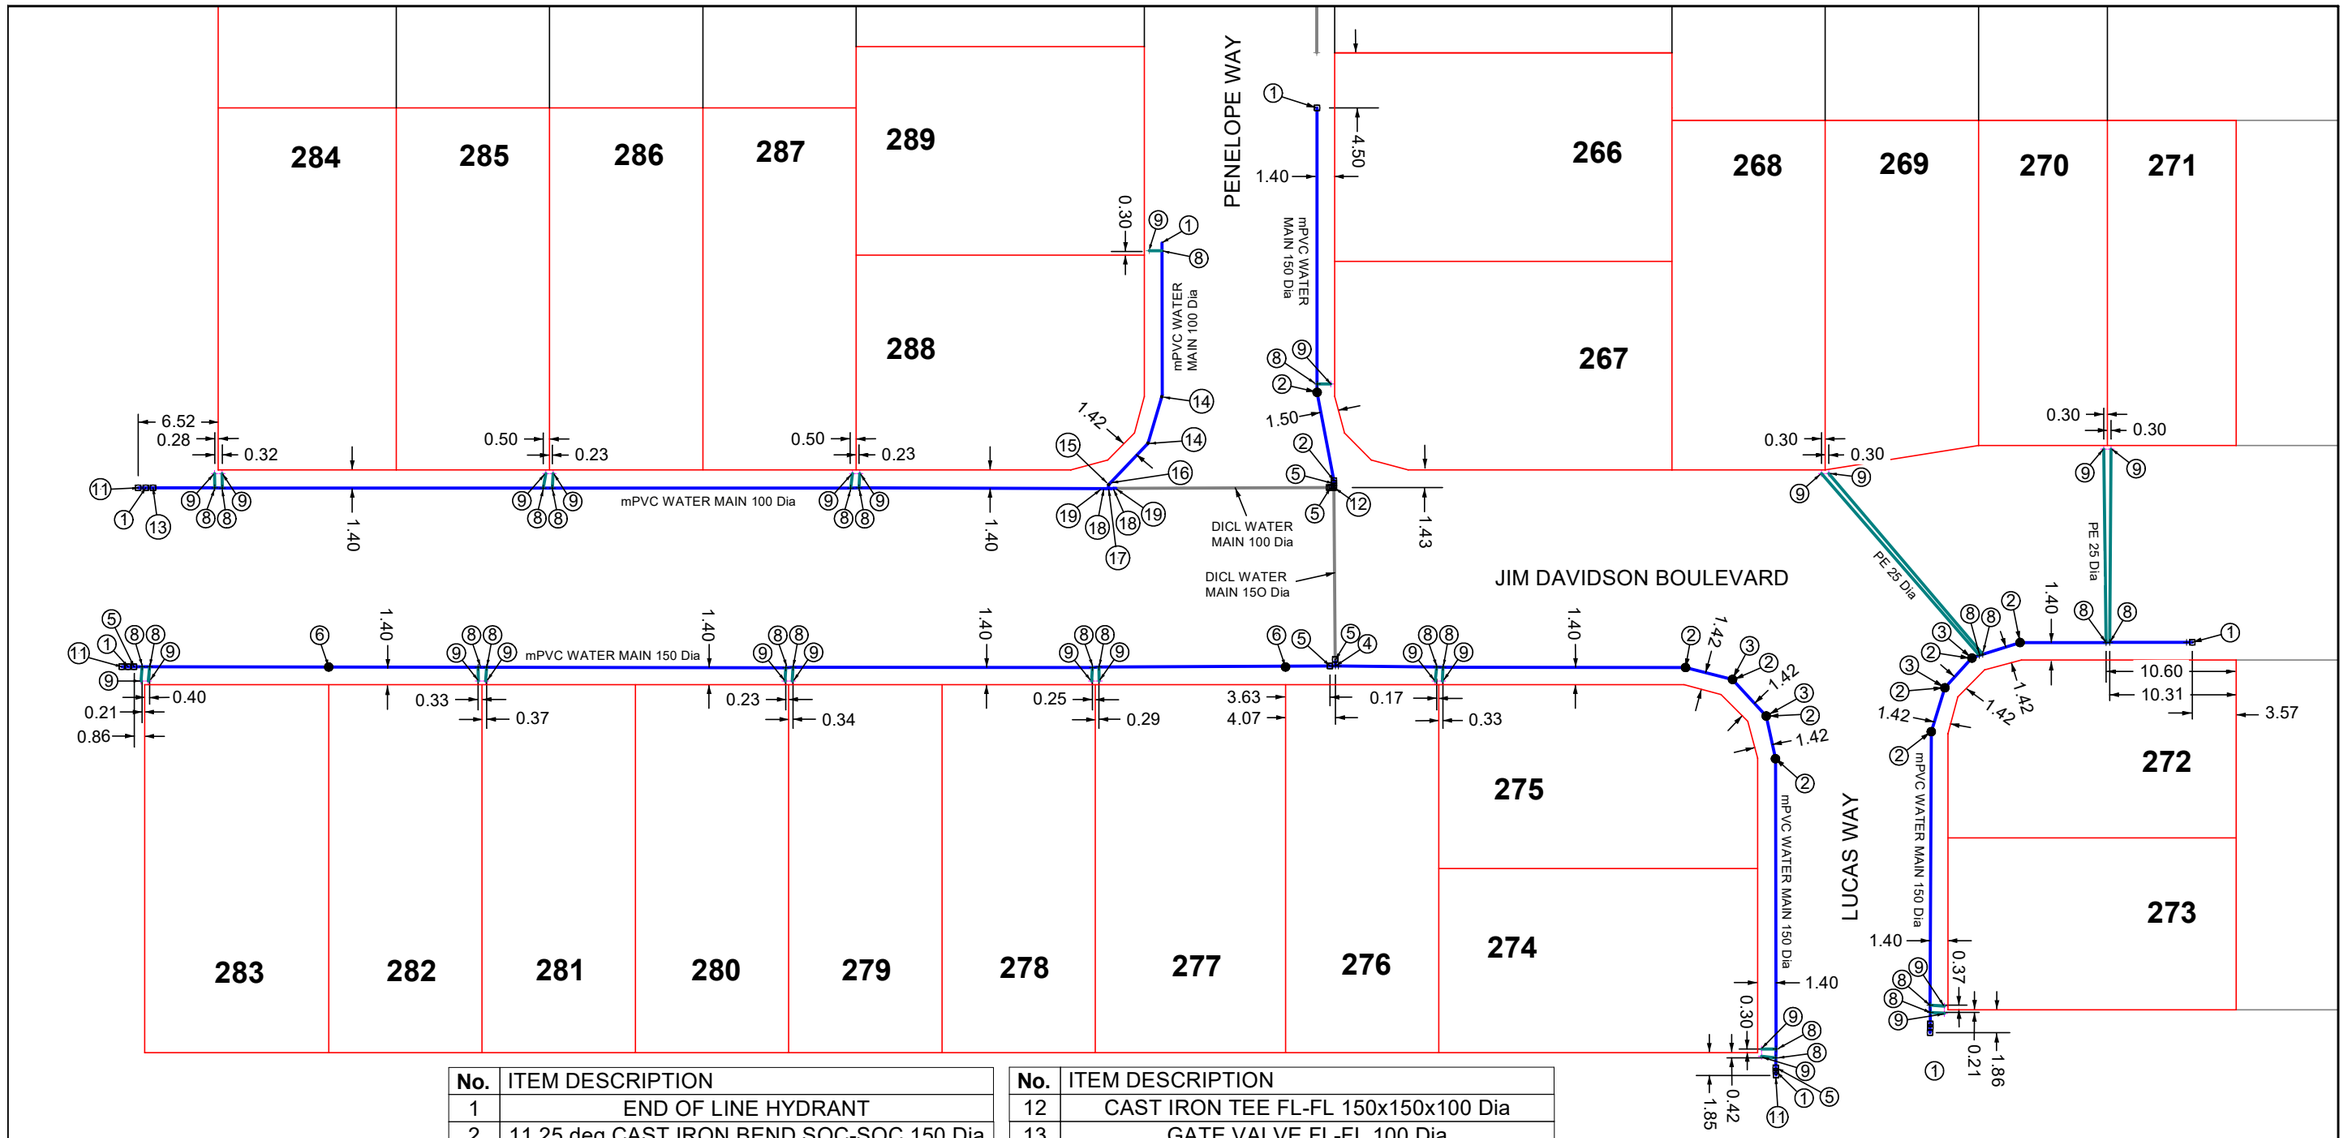

No.	ITEM DESCRIPTION
1	END OF LINE HYDRANT
2	11.25 deg CAST IRON BEND SOC-SOC 150 Dia
3	22.50 deg CAST IRON BEND SOC-SOC 150 Dia
4	CAST IRON TEE FL-FL 150x150x150 Dia
5	GATE VALVE FL-FL 150 Dia
6	HYDRANT TEE AND MARKER
7	CAST IRON CONNECTOR FL-SOC 150 Dia
8	BRASS TAPPING BAND 150 Dia
9	BRASS BALL VALVE 25 Dia
10	CAST IRON CONNECTOR FL-SPIG 150 Dia
11	CAST IRON END CAP 150 Dia

No.	ITEM DESCRIPTION
12	CAST IRON TEE FL-FL 150x150x100 Dia
13	GATE VALVE FL-FL 100 Dia
14	22.50 deg CAST IRON BEND SOC-SOC 100 Dia
15	45 deg CAST IRON BEND FL-FL 100 Dia
16	CONNECTOR FL-SOC 100 Dia
17	CAST IRON TEE FL-FL 100x100x100 Dia
18	CONNECTOR FL-SP 100 Dia
19	GIBAULT 100 Dia

1:500 @ A3

I, Neville H Volker hereby certify that the horizontal and vertical locations, dimensions shown on this plan are a true and correct record of the As Constructed information.

Project Name - DAVIDSONS AT BELIVAH - STAGE 3A

Company - BELIVAH Pty Ltd

Consultant - N H Volker & Co Pty Ltd

Reg No - 2753 DATE 15/07/2024 Signature - N H Volker

COUNCIL REF. No. - OW/170/2023

Davidson's At BELIVAH

ASSOCIATED CONSULTANT
N H VOLKER & Co. PTY. LTD.
P O Box 411
BEENLEIGH QLD 4207
EMAIL: nvolker@bigpond.net.au

JBT CONSULTING - BRAD TITE
PO Box 1350
SPRINGWOOD QLD 4150
PH 07 3207 3399 RPEQ 2673
Mbl. Phone: 0408 712 538 Email: btite@jbtconsulting.com.au

DAVIDSONS AT BELIVAH AS CONSTRCUTED WATER RETICULATION PLAN STAGE 3A

PROJECT : STAGE 3A
LOCATION: JIM DAVIDOSN BOULEVARD BELIVAH

SHEET TITLE: AS CONSTRU - WATER RETIC

DAB-3A-SWDAC

SHEET No. - 1 OF 1

REVISION. - D

BRAD TITE - RPEQ 2673

DATE: 08/04/2024

DATE: 15/07/2024
DRAWN: AB
EMAIL: nvolker@bigpond.net.au
PH: 0411 759 765