LOGAN CITY COUNCIL

ACCEPTED AS CONSTRUCTED DRAWING

This is the accepted As Constructed Drawing for Development Application COM/23/2021/A

It is accepted on the certification of the Surveyor/RPEQ. For the approved As Constructed Drawing please refer to the Approved Design As Constructed Drawing.

MACMILLAN LOOP

PENELOPE WAY

MACMILLAN LOOP

MH 2/8 CH 103.41 SL 31.00

HC SL 30.36 IL 29.89 100 Dia OB 59.46 SL 30.35 IL 29.79 L 2.69 FUTURE 406

HC SL 29.89 IL 29.30 100 Dia OB 45.52 SL 29.88 IL 29.16 L 2.55 FUTURE 407

HC SL 29.83 IL 28.93 100 Dia OB 31.95 SL 29.19 IL 28.54 L 2.54 FUTURE 408

HC SL 29.12 IL 28.15 100 Dia OB 19.47 SL 29.11 IL 28.13 L 2.48 FUTURE 409

HC SL 25.52 IL 27.42 100 Dia OB 3.48 SL 28.50 IL 27.39 L 2.63 FUTURE 410

HC SL 28.20 IL 27.14 100 Dia OB 0.00 SL 28.21 IL 27.06 L 2.05 FUTURE 411

MH 1/8 CH 35.35 SL 28.21

1 IN 11.00 2/7 - 3/7 150 Dia

1/8 - 2/8 150 Dia

1 IN 21.89

1 IN 30.41 4/7 - E/7 150 Dia

END E/6 CH 396.21 SL 26.25

END E/7 CH 135.57 SL 26.17

MH 4/7 CH 126.49 SL 25.97

HB 3/7 CH 122.76 SL 25.69 IL 24.14

HB 2/7 CH 119.03 SL 25.34 IL 23.88

MH 3/7 CH 114.97 SL 24.97

MH 7/6 CH 363.47 SL 25.78

HB 1/6 CH 327.00 SL 23.99 IL 22.05

1 IN 93.26

1 IN 12.50 3/7 - 4/7 150 Dia

1 IN 20.43 2/7 - 3/7 150 Dia

1 IN 21.80 6/6 - 7/6 150 Dia

MH 6/6 CH 303.07 SL 22.81

HB 1/9 CH 5.68 SL 23.23 IL 21.30

HB 2/9 CH 9.63 SL 23.36 IL 21.42

1/9 - E/9 150 Dia 1 IN 78.66

END E/9 CH 28.39 SL 23.41

MH 1/9 CH 17.44 SL 23.47

1 IN 33.59 6/6 - 1/9 150 Dia

MH 2/7 CH 67.93 SL 22.55

HB 1/7 CH 55.45 SL 21.94 IL 20.68

1 IN 30.58 1/7 - 2/7 150 Dia

1 IN 25.81 5/6 - 6/6 150 Dia

MH 1/7 CH 15.90 SL 20.84

EXT MH 5/6 CH 234.09 SL 20.62

5/6 - 1/7 1 IN 19.88 150 Dia

226 225 224 223 222 221 220 219 218 217 216 20

264 263 262 261 260 259 258 257 256 241 242 243 244 245 246 247 248 249 254 255 253 252 251 250

66 67 92

1:500 @ A3

Project Name - DAVIDSONS AT BELIVAH - STAGE 2B

Company - BELIVAH Pty Ltd

Consultant - N H Volker & Co Pty Ltd

Reg No - 2753 DATE 13/05/2023 Signature -

I, Neville H Volker hereby certify that the horizontal and vertical locations, dimensions shown on this plan are a true and correct record of the As Constructed information.

COUNCIL REF. No. - COM/23/2021/A

Davidson's At BELIVAH

ASSOCIATED CONSULTANT
N H VOLKER & Co. PTY. LTD.
P O Box 411
BEENLEIGH QLD 4207
EMAIL: nvolker@bigpond.net.au

JBT CONSULTING - BRAD TITE
PO Box 1350
SPRINGWOOD QLD 4150
PH 07 3207 3399 RPEQ 2673
Mbl. Phone: 0408 712 538 Email: btite@jbtconsulting.com.au

DAVIDSONS AT BELIVAH AS CONSTRCUTED SEWER RETICULATION PLAN STAGE 2B

PROJECT : STAGE 2B

LOCATION: MACMILLAN LOOP, BELIVAH

SHEET TITLE: AS CONSTRUCTED - SEWER RETIC

DRAWING No. - DAB-2B-S01AC

SHEET No. - 1 OF 1

REVISION. - A

APPROVED:

BRAD TITE - RPEQ 2673

DATE: 13/05/2023

DATE: 13/05/2023
DRAWN: AB
EMAIL: nvolker@bigpond.net.au
PH: 0411 759 765

LOGAN CITY COUNCIL

ACCEPTED AS CONSTRUCTED DRAWING

This is the accepted As Constructed Drawing for Development Application

COM/23/2021/A

It is accepted on the certification of the Surveyor/RPEQ. For the approved As Constructed Drawing please refer to the Approved Design As Constructed Drawing.

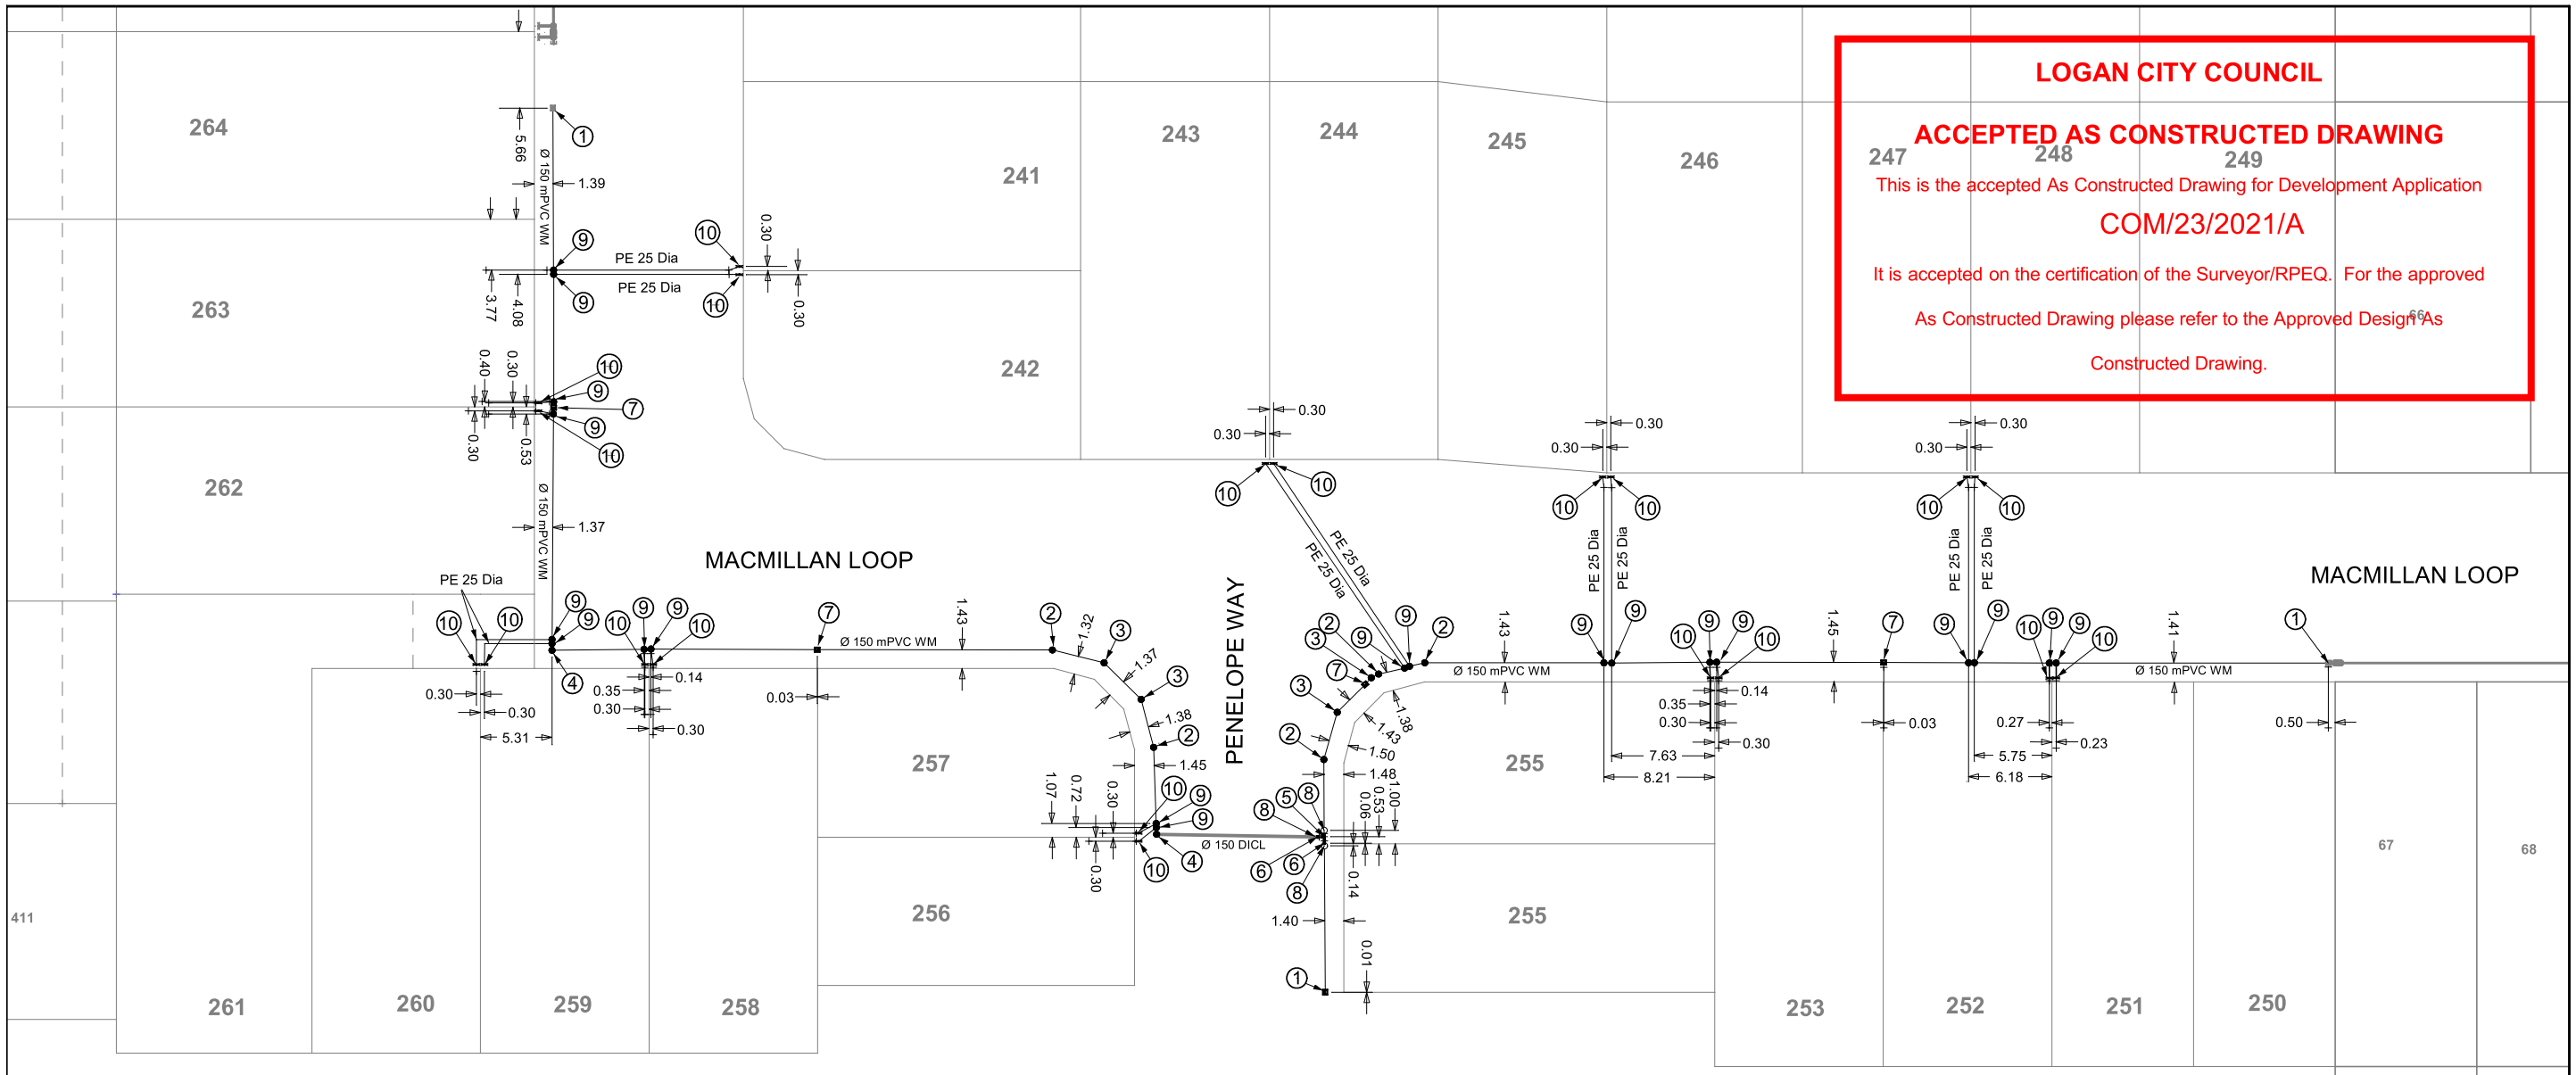

Project Name - DAVIDSONS AT BELIVAH - STAGE 2B

Company - BELIVAH Pty Ltd

Consultant - N H Volker & Co Pty Ltd

Reg No - 2753 DATE 13/05/2023 Signature -

I, Neville H Volker hereby certify that the horizontal and vertical locations, dimensions shown on this plan are a true and correct record of the As Constructed information.

1:500 @ A3

No.	ITEM DESCRIPTION
1	END OF LINE HYDRANT
2	11.25 deg CAST IRON BEND SOC-SOC 150 Dia
3	22.50 deg CAST IRON BEND SOC-SOC 150 Dia
4	90 deg CAST IRON BEND SOC-SOC 150 Dia
5	CAST IRON TEE FL-FL 150x150x150 Dia
6	GATE VALVE FL-FL 150 Dia
7	HYDRANT TEE AND MARKER
8	CAST IRON CONNECTOR FL-SOC 150 Dia
9	BRASS TAPPING BAND 150 Dia
10	BRASS BALL VALVE 25 Dia
11	45 deg CAST IRON BEND SOC-SOC 150 Dia
12	CAST IRON CONNECTOR FL-SPIG 150 Dia
13	CAST IRON END CAP 150 Dia

COUNCIL REF. No. - COM/23/2021/A

Davidson's At Belivah

ASSOCIATED CONSULTANT
N H VOLKER & Co. PTY. LTD.
P O Box 411
BEENLEIGH QLD 4207
EMAIL: nvolker@bigpond.net.au

JBT CONSULTING - BRAD TITE
PO Box 1350
SPRINGWOOD QLD 4150
PH 07 3207 3399 RPEQ 2673
Mbl. Phone: 0408 712 538 Email: btite@jbtconsulting.com.au

DAVIDSONS AT BELIVAH AS CONSTRCUTED WATER RETICULATION PLAN STAGE 2B

PROJECT : STAGE 2B
LOCATION: MACMILLAN LOOP, BELIVAH

SHEET TITLE: AS CONSTRUCTED - WATER RETICULATION

DRAWING No. - DAB-2B-WAC

SHEET No. - 1 OF 1

REVISION. - A

APPROVED:

BRAD TITE - RPEQ 2673

DATE: 13/05/2023

DATE: 13/05/2023
DRAWN: AB
EMAIL: nvolker@bigpond.net.au
PH: 0411 759 765

Project Name - DAVIDSONS AT BELIVAH - STAGE 2B

Company - BELIVAH Pty Ltd

Consultant - N H Volker & Co Pty Ltd

Reg No - 2753 DATE 13/05/2023 Signature - M H Volk

I, Neville H Volker hereby certify that the horizontal and vertical locations, dimensions shown on this plan are a true and correct record of the As Constructed information.

LOGAN CITY COUNCIL

ACCEPTED AS CONSTRUCTED DRAWING

This is the accepted As Constructed Drawing for Development Application

COM/23/2021/A

It is accepted on the certification of the Surveyor/RPEQ. For the approved As Constructed Drawing please refer to the Approved Design As Constructed Drawing.

FUTURE 404
HC
SL 30.96
IL 30.40
L 1.00
100 Dia
RW PIT
RW 404
600 x 600
SL 31.07
2.65
4.34
IL 30.35

FUTURE 405
225dia PVC
(-4.40%)
HC
SL 30.35
IL 29.74
L 1.00
100 Dia
RW PIT
RW 405
600 x 600
SL 30.69
1.79
4.16
IL 29.69
IL 29.62

FUTURE 406
225dia PVC
(-4.18%)
HC
SL 29.90
IL 29.14
L 1.00
100 Dia
RW PIT
RW 406
600 x 600
SL 29.87
2.19
4.23
IL 29.09
IL 29.05

FUTURE 407
225dia PVC
(-4.42%)
HC
SL 29.20
IL 28.50
L 1.00
100 Dia
RW PIT
RW 407
600 x 600
SL 29.50
1.93
4.34
IL 28.45
IL 28.39

FUTURE 408
HC
SL 28.53
IL 27.86
L 1.00
100 Dia
225dia PVC
(-4.40%)
RW PIT
RW 408
600 x 600
SL 28.48
1.99
4.36
IL 27.81
IL 27.77

FUTURE 409
HC
SL 28.53
IL 27.22
L 1.00
100 Dia
225dia PVC
(-4.32%)
RW PIT
RW 409
600 x 600
SL 28.31
1.94
4.40
IL 27.17
IL 27.12

FUTURE 410
HC
SL 28.23
IL 27.34
L 1.00
100 Dia
RW PIT
RW 410
900 x 600
SL 28.14

225dia PVC
(-6.24%)
IL 26.64
IL 26.19
1.61
4.60

300dia RCP (-5.34%)
IL 25.28
IL 24.60
IL 23.87

RW PIT
RW 261
600 x 600
SL 27.06
1.78
2.45
HC
SL 27.92
IL 26.41
L 1.00
100 Dia

RW PIT
RW 260
600 x 600
SL 26.32
1.96
2.74
HC
SL 26.27
IL 25.66
L 1.00
100 Dia

RW PIT
RW 259
600 x 600
SL 25.63
1.94
2.36
HC
SL 26.05
IL 24.77
L 1.00
100 Dia

MACMILLAN LOOP

SWD INLET
1/B
SL 25.86
375dia RCP
(-1.31%)
IL 24.72
IL 24.67
IL 24.59

SWD INLET
2/B
SL 25.79
375dia RCP (-4.75%)
IL 23.76

SWD MH
3/B
SL 25.19
IL 23.53
IL 23.37
375dia RCP (-3.08%)
IL 22.72
IL 22.65

SWD INLET
4/B
SL 23.98
450dia RCP (-5.53%)
IL 21.61
IL 20.75

SWD INLET
4A/B
SL 23.09
IL 20.80

375dia RCP
(-4.42%)
IL 21.17

SWD INLET
1/4B
SL 23.28

PENELOPE WAY

450dia RCP (-2.23%)

SWD INLET
1/5B
SL 20.87
IL 19.64
IL 19.54

375dia RCP
(-4.42%)

SWD INLET
5/B
SL 20.74
IL 19.44
IL 19.43

223 222 221 220 219 218 217 216
226
225
224
241
243 244 245
246 247 248 249
264
263
242
262
257
256
255
255
261 260 259 258
253 252 251 250

411
N
1:500 @ A3

COUNCIL REF. No. - COM/23/2021/A

Davidson's At BELIVAH	ASSOCIATED CONSULTANT N H VOLKER & Co. PTY. LTD. P O Box 411 BEENLEIGH QLD 4207 EMAIL: nvolker@bigpond.net.au	JBT CONSULTING - BRAD TITE PO Box 1350 SPRINGWOOD QLD 4150 PH 07 3207 3399 RPEQ 2673 Mbl. Phone: 0408 712 538 Email: btite@jbtconsulting.com.au	**DAVIDSONS AT BELIVAH AS CONSTRCUTED STORMWATER & ROADS PLAN STAGE 2B**	PROJECT : STAGE 2B LOCATION: MACMILLAN LOOP, BELIVAH SHEET TITLE: AS CONSTRUCTED - ROADS & STORMWATER	DRAWING No. - DAB-2B-SWDAC SHEET No. - 1 OF 1 REVISION. - A	**APPROVED:** **BRAD TITE - RPEQ 2673** **DATE: 13/05/2023**	DATE: 13/05/2023 DRAWN: AB EMAIL: nvolker@bigpond.net.au PH: 0411 759 765